


three inches = one foot
one and one half inches = one foot
one inch = one foot
three quarters inch = one foot
one half inch = one foot
three eighths inch = one foot
one quarter inch = one foot
one eighth inch = one foot

three inches = one foot
one and one half inches = one foot
one inch = one foot
three quarters inch = one foot
one half inch = one foot
three eighths inch = one foot
one quarter inch = one foot
one eighth inch = one foot


35% SD SUBMITTAL	11/14/2012
35% SD REVISION 1	11/26/2012
65% DD SUBMITTAL	12/20/2012
95% CD SUBMITTAL	01/30/2013
100% CD SUBMITTAL	02/27/2013
BIDDING DOCUMENTS	06/10/2013
AMENDMENT 3	9-3-2013
Revisions:	Date

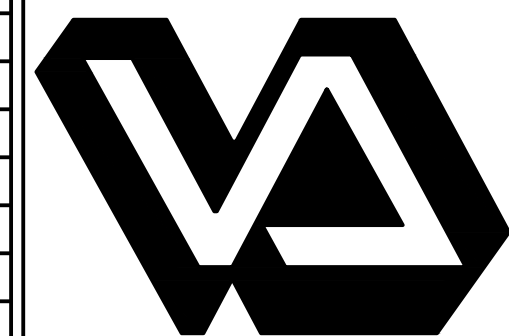

Dept. of Veterans Affairs
Richard L. Roudebush
VA Medical Center
1481 W. 10th Street
Indianapolis, IN 46202

CERTIFIED BY:

NORTH REFERENCE

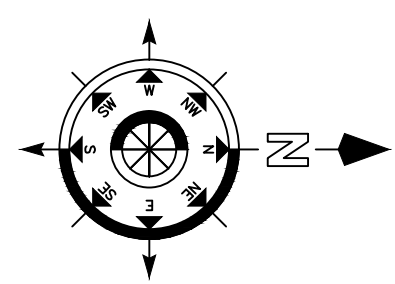

ARCHITECT/ENGINEERS:

9245 Calumet Ave, Suite 205,
Munster, IN 46321
(219) 836-2120 Fax (219) 836-1129



Drawing Title ELECTRICAL BASEMENT GENERATOR ROOMS POWER PLAN	
PROJECT ENGINEER John Flwowski	Approved Engineering Chief
SCALE	Approved Service Chief

Project Title RENOVATE SPS	
Location BASEMENT A-WING	
Date 6/10/2013	Checked JS
Drawn DS	


Project Number 583-12-107	Engineering and Facilities Management Services
Building Number 1	
Drawing Number EP-400	Department of Veterans Affairs
3FY12	
49 of 55	

GENERAL NOTES:

- ELECTRICAL CONTRACTOR TO VERIFY EXISTING LOADS ON THE INDICATED CIRCUIT BREAKER PANELS AND DETERMINE IF ANY NEW LOADS ARE REQUIRED THAT IT WILL NOT EXCEED THE RATING OF EACH PANEL. IF A POTENTIAL OVERLOAD PROBLEM EXISTS, CONTRACTOR IS TO PROVIDE AN ALTERNATE SOLUTION AND SECURE THE APPROVAL OF THE VA ON SITE REPRESENTATIVE.
- ANY SITE MODIFICATION NOT SHOWN ON DRAWINGS SHALL BE MARKED-UP ON AN EXISTING DRAWING. CONTRACTOR SHALL SUBMIT A MARKED UP SET TO THE VA REPRESENTATIVE FOR AS-BUILT PURPOSES AT THE CONCLUSION OF THE PROJECT.
- (1) EACH BRANCH CIRCUIT HOMERUN SHALL HAVE NO MORE THAN THREE CIRCUITS. EACH BRANCH CIRCUIT HOMERUN SHALL HAVE A SEPARATE GREEN INSULATED EQUIPMENT GROUNDING CONDUCTOR.
- RECEPTACLES TO BE NEMA 5-20R.
- EMERGENCY RECEPTACLES AND FACEPLATES TO BE STAINLESS STEEL, PAINTED RED IN COLOR AND ENGRAVED WITH WHITE LETTERING TO DESIGNATE POWERED FROM EMERGENCY.
- ALL NORMAL RECEPTACLES AND FACEPLATES SHALL BE STAINLESS STEEL WITH IVORY DEVICES.
- ELECTRICAL CONTRACTOR TO FIELD VERIFY MOST APPROPRIATE ROUTING OF CONDUIT AND WIRING.
- ELECTRICAL OUTLETS INSTALLED WITH GROUND PLUG UP UNLESS OTHERWISE NOTED ON THIS DRAWING OR ARCHITECTURAL ELEVATION DRAWINGS
- CONTRACTOR TO PROVIDE A NEW PANEL DESIGNATION FOR EACH PANEL CIRCUIT AND BREAKERS THAT WERE MODIFIED.

PHASE 1 PLAN NOTES:

- EMERGENCY GENERATOR ROOM
INSTALL NEW EMERGENCY 480v 600A IN ABHEDP1 TO ATS-1AB1
- INSTALL CONDUIT AND CABLE TO ATS-1AB1 FROM 600A CIRCUIT BREAKER
- ELECTRICAL SWITCHGEAR ROOM
INSTALL NEW 400A ATS-1AB1
- INSTALL NEW NORMAL 480v 600A IN AMS1 TO ATS-1AB1
- INSTALL CONDUIT AND CABLE TO ATS-1AB1 FROM 600A CIRCUIT BREAKER
- INSTALL CONDUIT AND CABLE FROM ATS-1AB1 TO NEW PANEL ABHEQ3 LOCATED IN MECHANICAL ROOM AB-148. SEE 1/EP-100

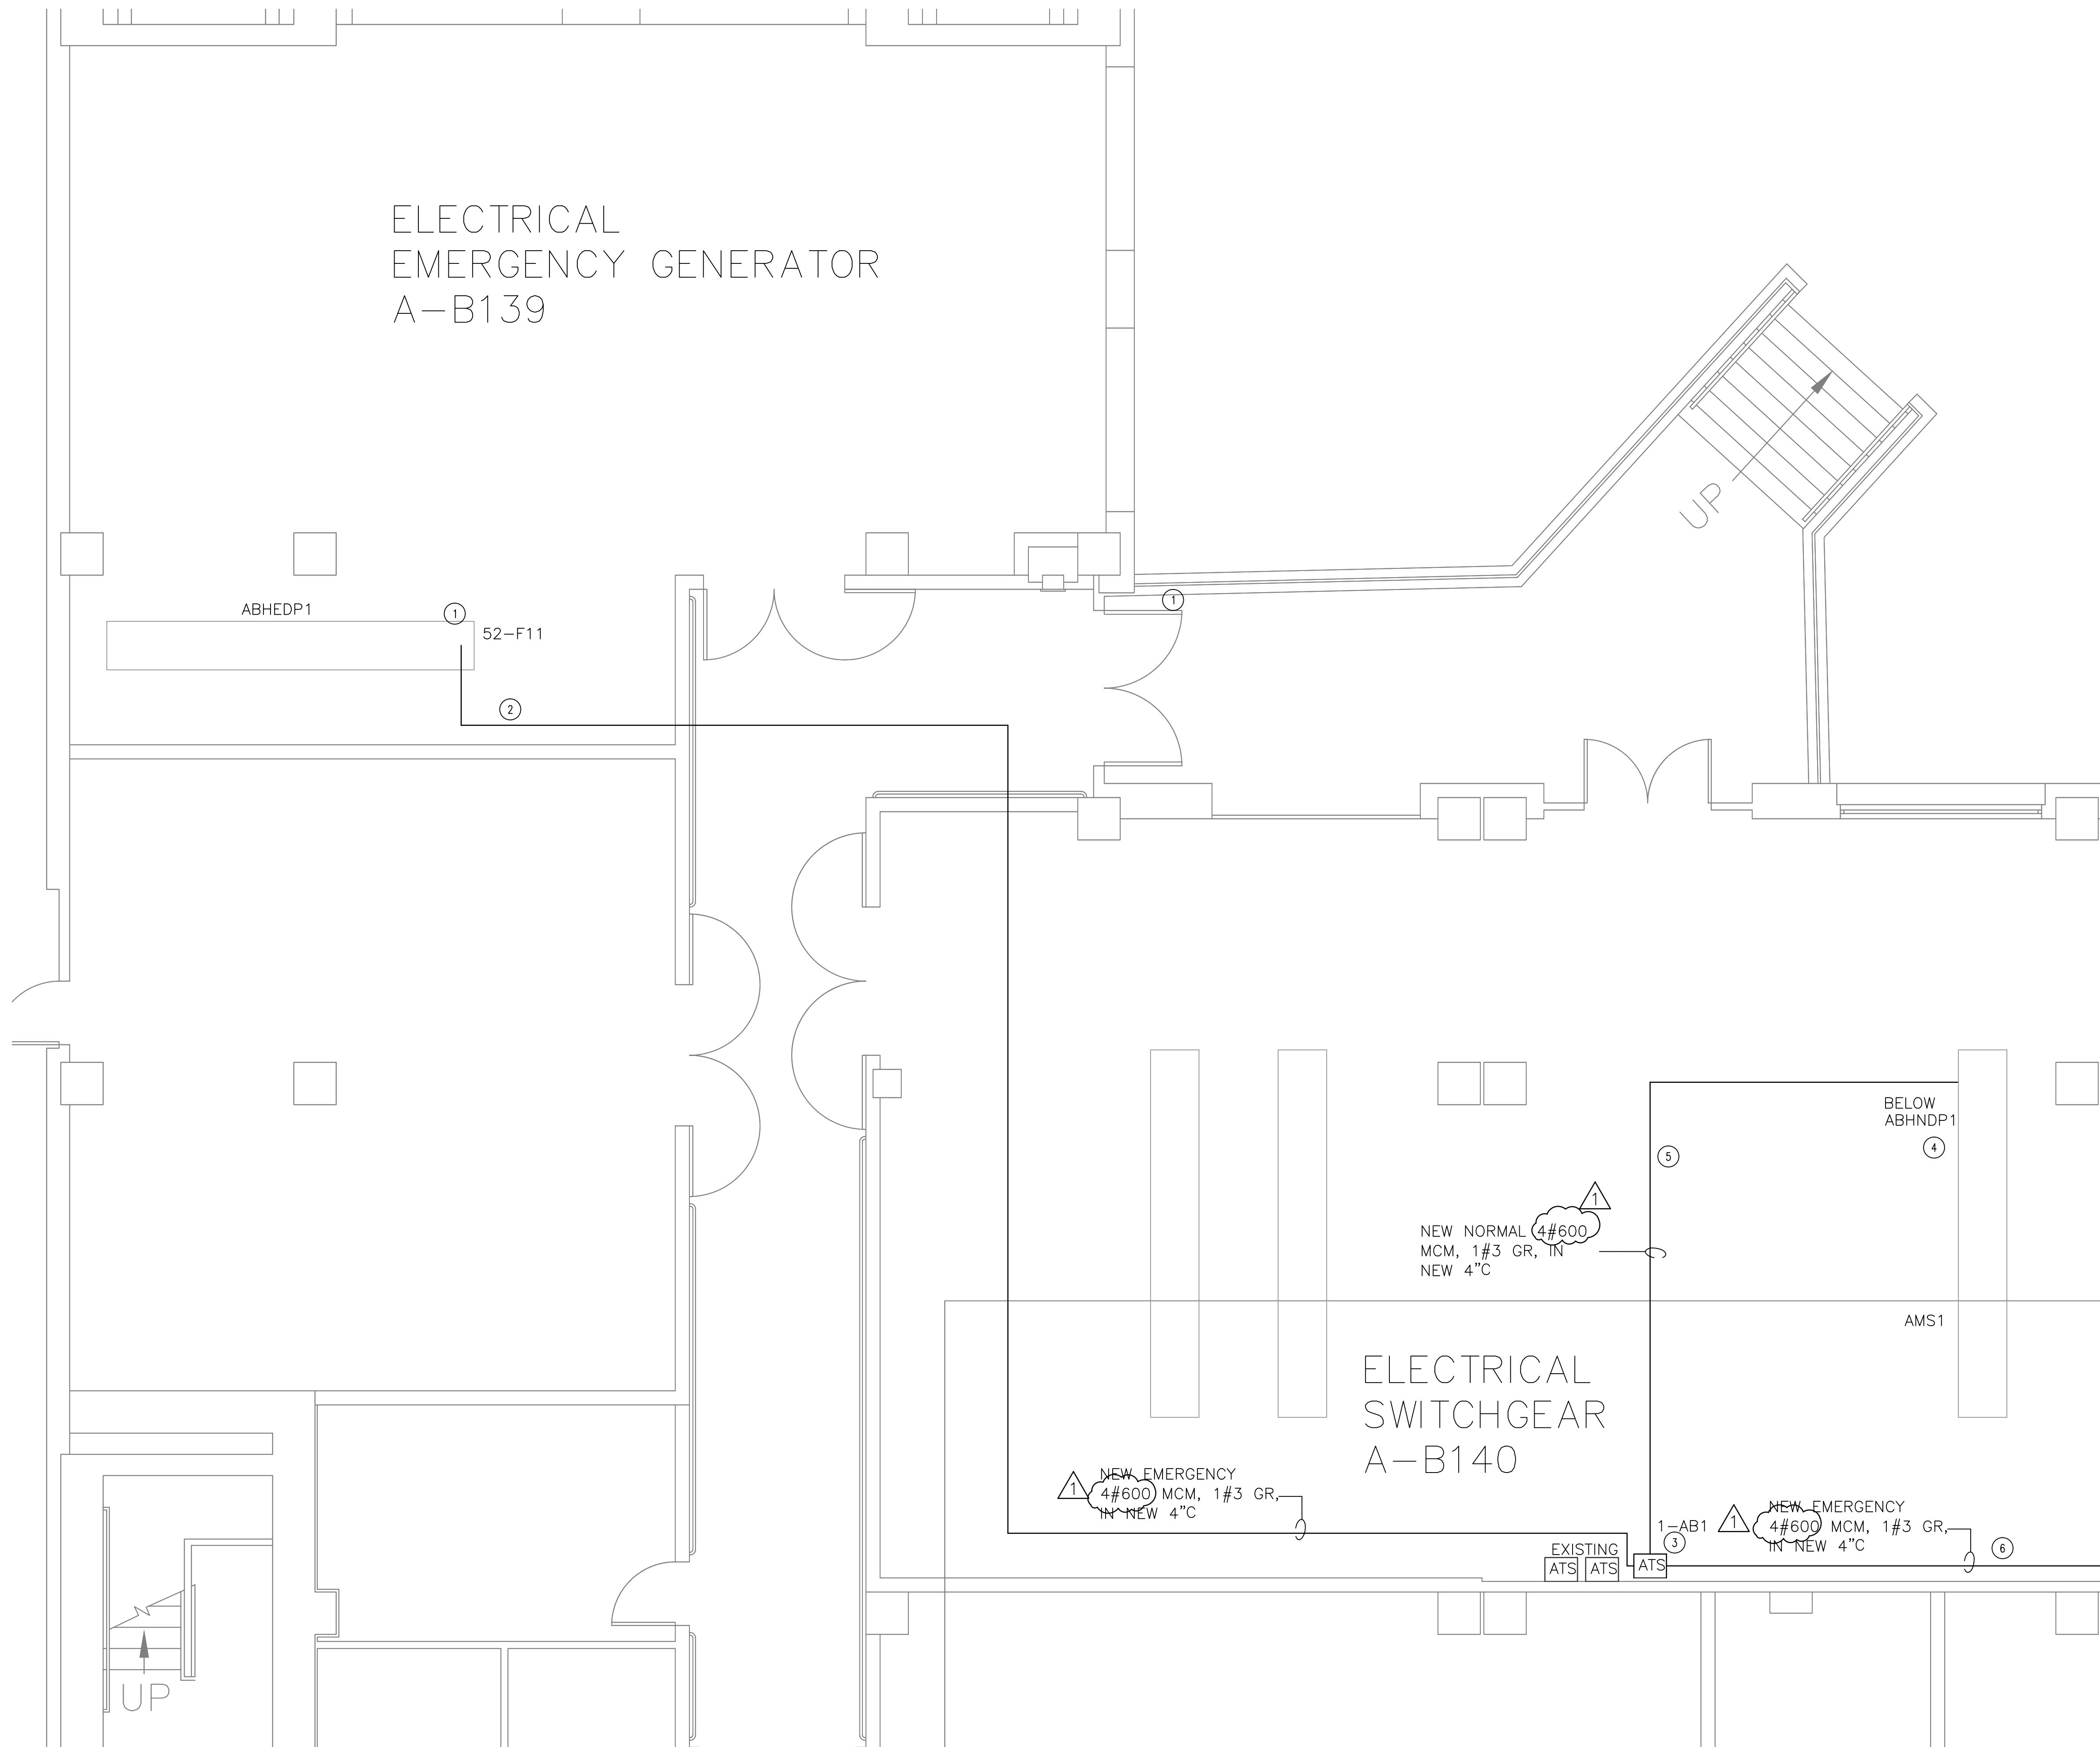

ELECTRICAL ENLARGED POWER PLAN PHASING PLAN – PHASE 1

SCALE: 1/4" = 1'-0"



BIDDING DOCUMENTS
FULLY SPRINKLERED